


LOCATION PLAN

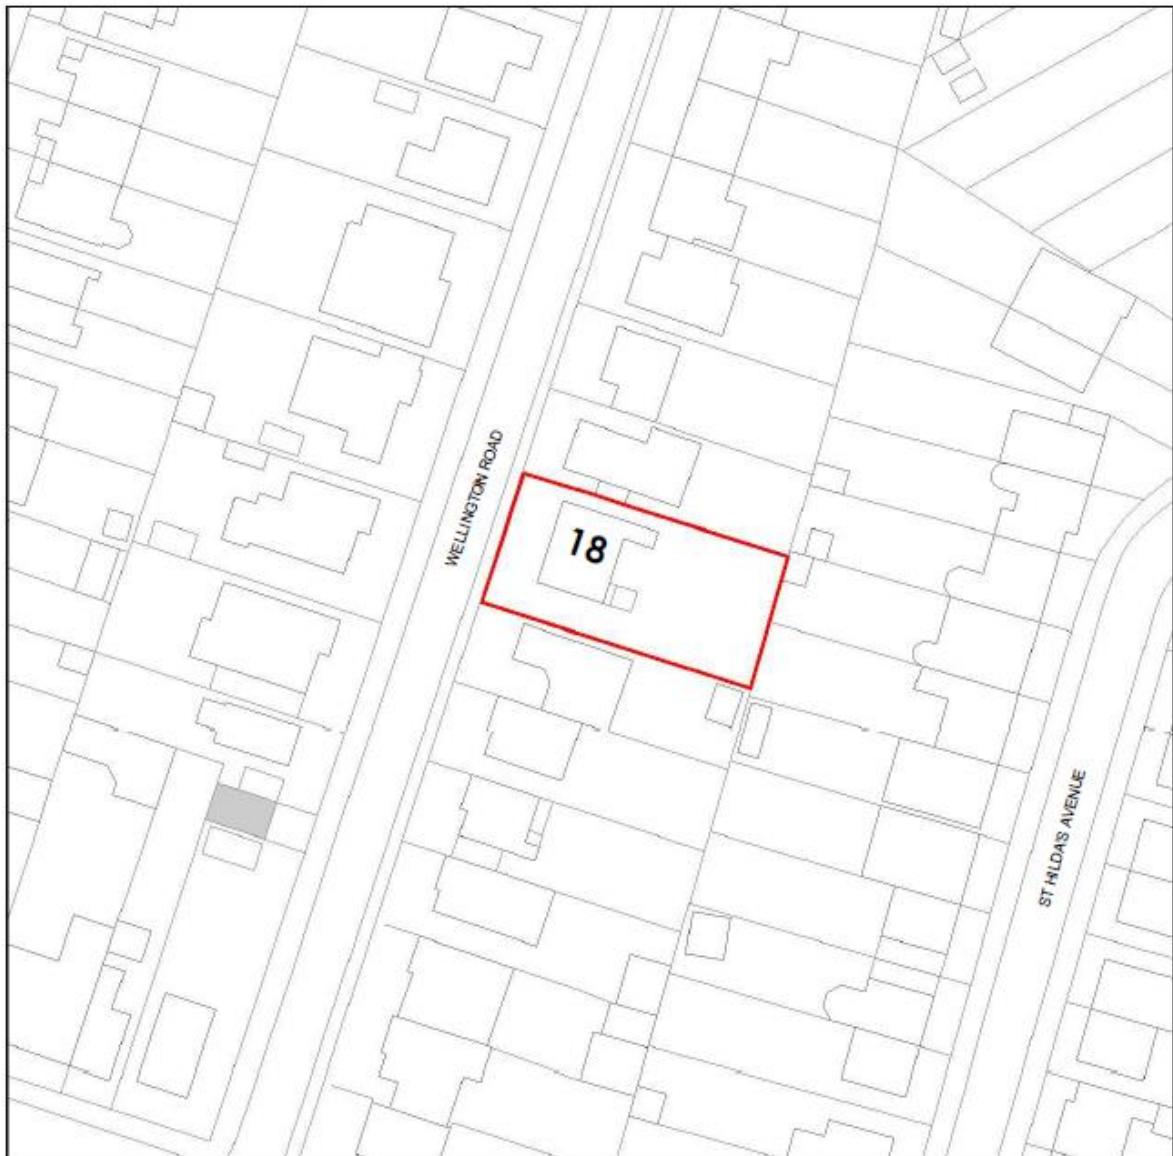

Proposed OS Map⁰
1 : 1250



APPROVED FRONT ELEVATION (APPLICATION 24/01542/FUL)



AS BUILT FRONT ELEVATION




APPROVED REAR ELEVATION (APPLICATION 24/01542/FUL)




AS BUILT REAR ELEVATION




APPROVED GROUND FLOOR PLAN (APPLICATION 24/01542/FUL)

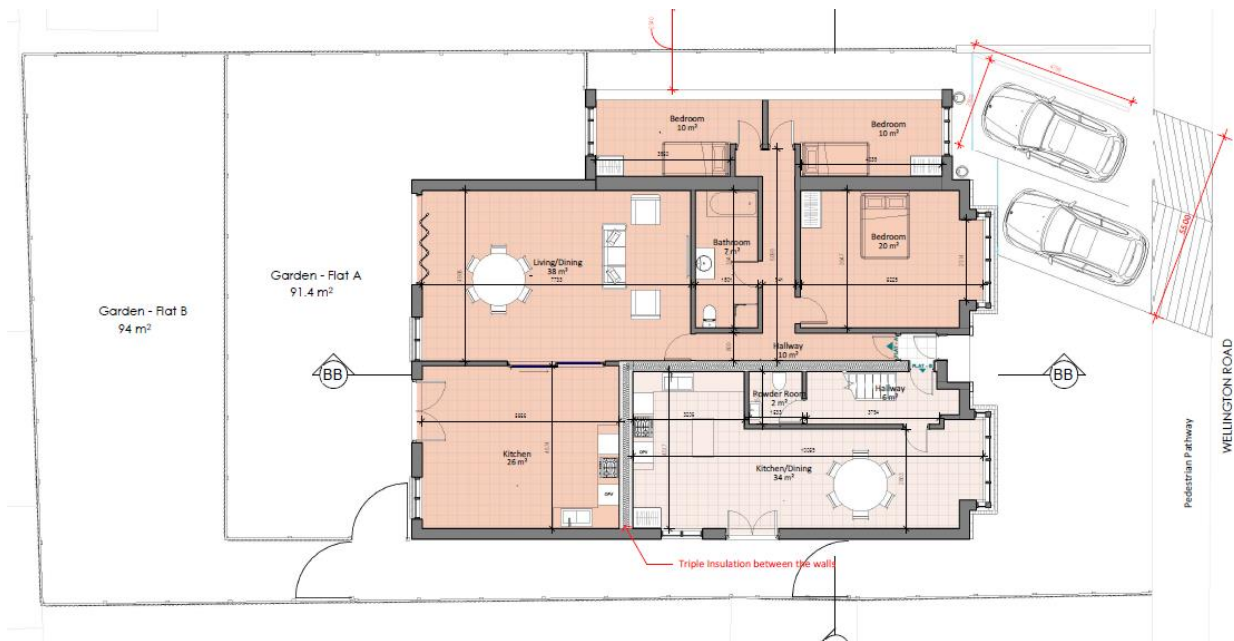

AS BUILT GROUND FLOOR PLAN

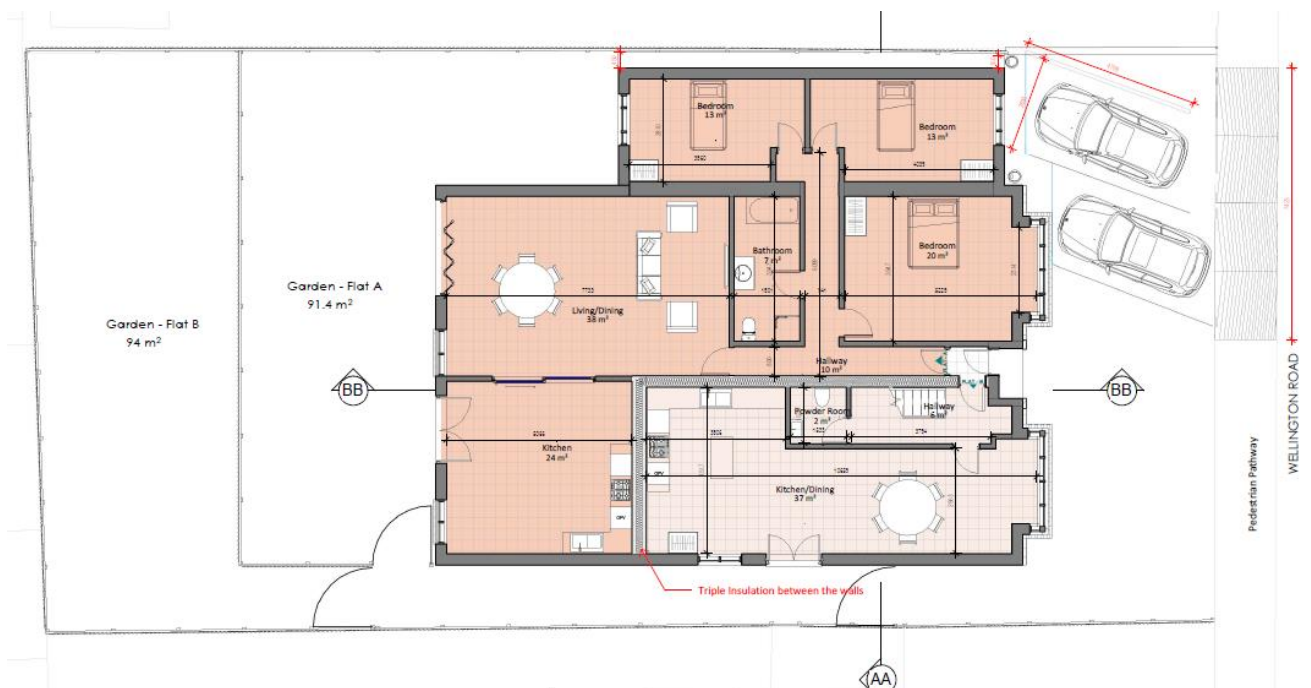

APPROVED ROOF PLAN (APPLICATION 24/01542/FUL)

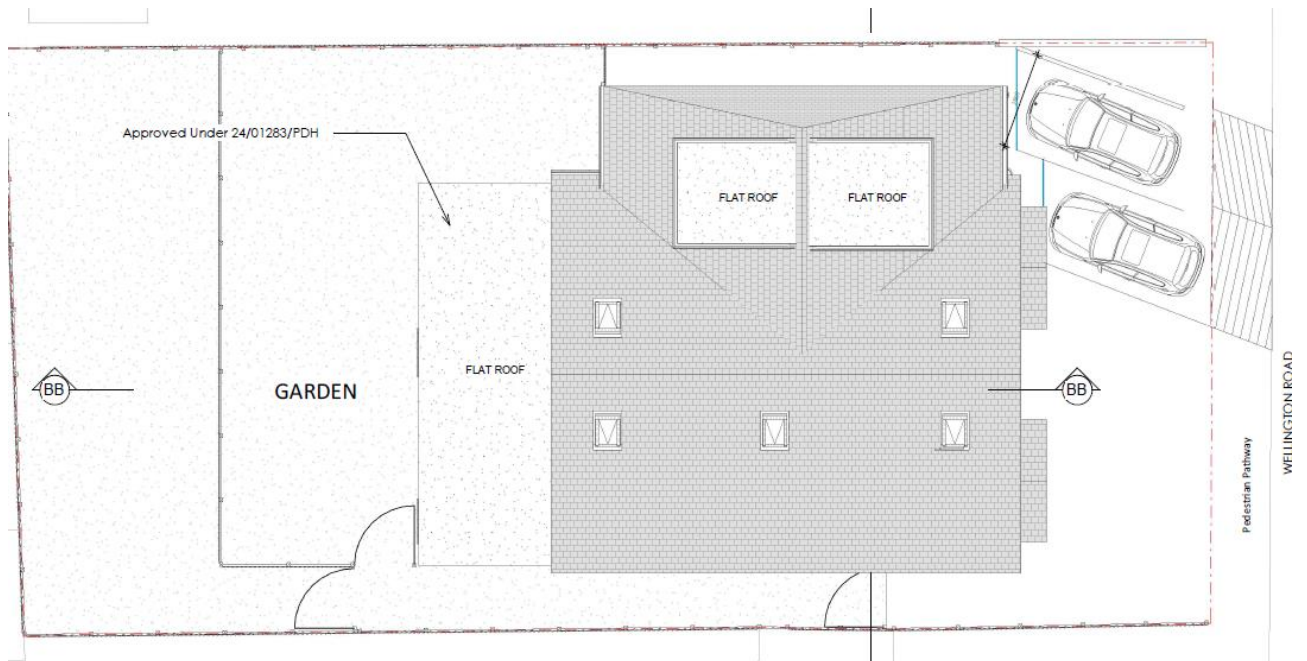

AS BUILT ROOF PLAN

